


11,368 SF - 37th Floor

**Bay Adelaide Centre - West Tower**  
 333 Bay Street, Toronto, Ontario

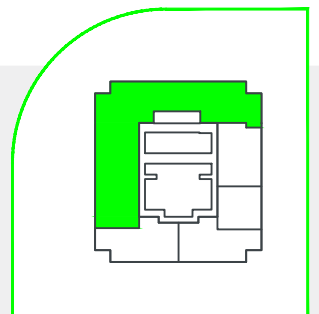

**Brookfield**  
 Properties